


	0 – 15' IDENTIFY Best detail for positive identification (facial features clear)
	15 – 30' RECOGNIZE Good detail to recognize person (clothing, general features)
	30 – 60' DETECT Detect presence and activity (limited detail)

Horizontal Field of View

40°

- Distances measured from camera lens

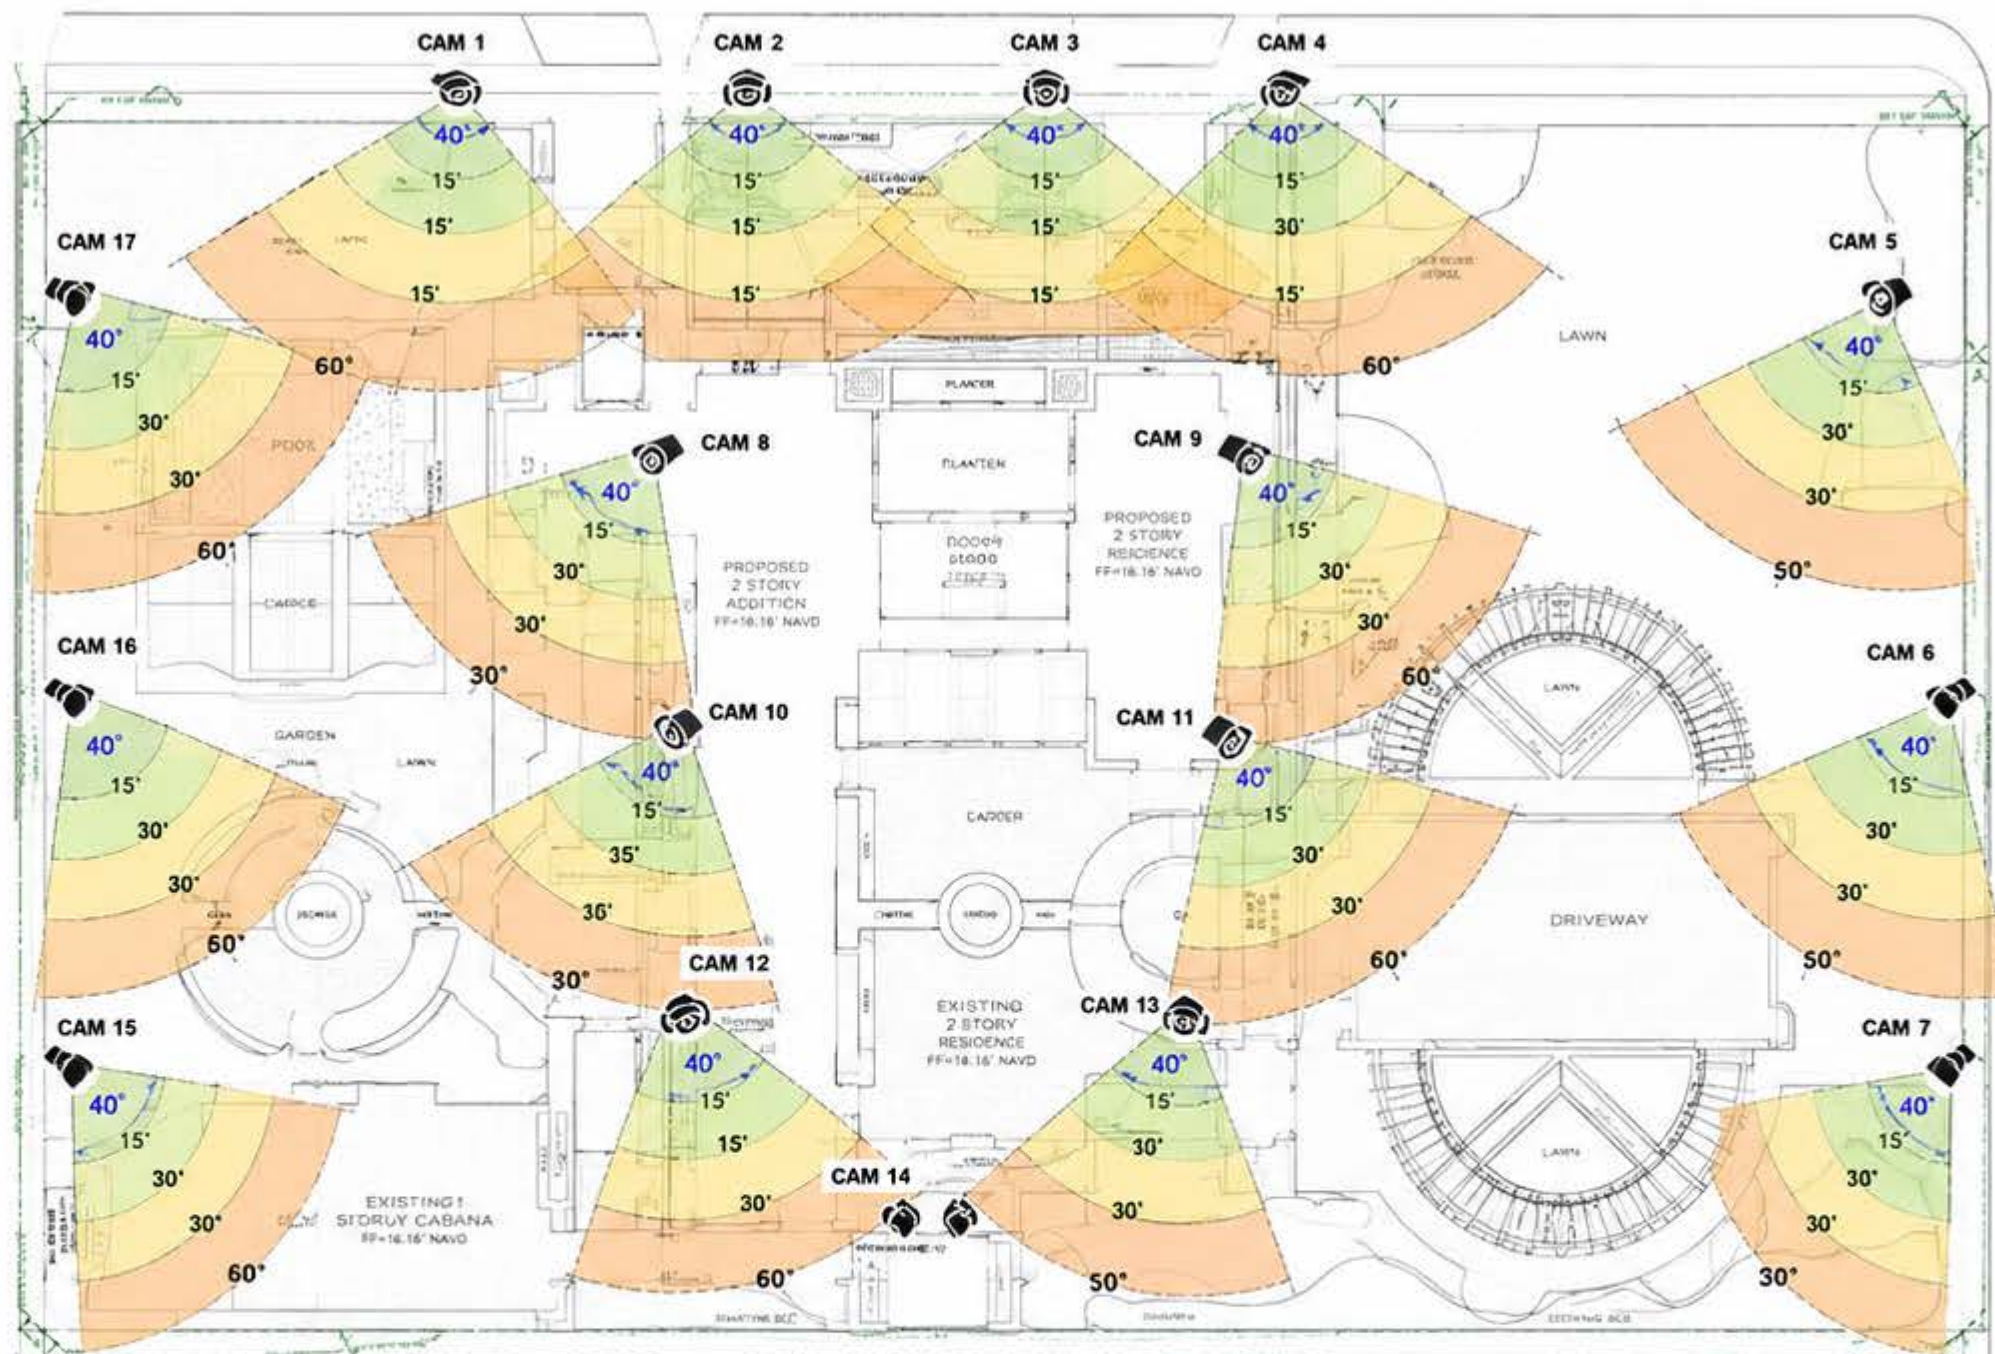

Best detail for positive identification
(facial features clear)



5'

10'

15'

Good detail to recognize person
(clothing, general features)



15'

20'

30"

Detect presence and activity
(limited detail)



30'

45'

60°

0 – 15' IDENTIFY

15 – 30' RECOGNIZE

30 – 60' DETECT

All cameras: 40°
horizontal field of view



PRIVATE RESIDENCE
PALM BEACH, FL 33480

This document is the property of XXXX.
Any unauthorized use or reproduction of
this document, in whole or part,
is prohibited.

REV	DESCRIPTION	DATE
1	First Release	4/21/20
2	Progress - update	01/08/21
3	Final Review w/ GC & Architect	01/18/21
4	Hyperlink to documents sign & certify	01/21/21
5	Permit Revision 1	6/01/21
6	Security Revised as built	6/05/21

DATE:

04/21/20

SCALE

$$1/4'' = 1'-0''$$

DRAWN BY

CHECKED BY:

CLIENT REP

DRAFTING NO.

LV-S

SITE CAMERA STUDY LV & CONDUIT PLAN

REFER TO "NOTE" PAGE FOR LEGENDS AND NOTES



**PRIVATE RESIDENCE
123 MAIN STREET
HOMETOWN, FL**

[illegible]06/03/21

DOI: 10.1002/nia

MI.C	00000-00000	0000000000
------	-------------	------------

CAM-1